34

SUBMARINE TENDER AS 34

ORDER OF PLANS	PLATE NO.
COVER SHEET	1
GENERAL INFORMATION	2
OUTBOARD PROFILE	3
INBOARD PROFILE	4
04 LEVEL & ABOVE	5
03 LEVEL	6
02 LEVEL	7
01 LEVEL	8
MAIN DECK	9
SECOND DECK	10
THIRD DECK	11
FOURTH DECK	12
FIRST PLATFORM	13
SECOND PLATFORM	14
HOLD	15
INNER BOTTOM	16
MIDSHIP & TYPE SECTIONS	17

CORRECTED TO SUIT SHIP

PLACE	DATE	APPROVED

BOOKLET OF
GENERAL PLANS
SELECTED RECORD PLAN

AS 34 - 845 - 2105517

THE INGALLS SHIPBUILDING CORP.

DATE APPROVED

GENERAL DIMENSIONS - HULL

FRAME SPACING	4'-0'
LENGTH BETWEEN PERPENDICULARS	620'-0"
*LENGTH OVERALL	643'-7⅜"
BREADTH EXTREME MOLDED MAXIMUM	85'-0"
DRAFT ABV BOTTOM OF KEEL CORRESPONDING TO FULL LOAD DISPLACEMENT	23'-3"
DRAFT ABV LOWEST PROJ BELOW BOT OF KEEL (BILGE KEEL) FULL LOAD DISPLACEMENT	25'-8"

HEIGHT ABOVE BOTTOM OF KEEL

*TOPMOST PART OF SHIP (TOP OF AS-1018/URC ANTENNA)	175'-9⅜"
*MASTHEAD LIGHT	124'-5¼"
*RANGE LIGHT	139'-5¼"
*HORIZONTAL DISTANCE BETWEEN MASTHEAD AND RANGE LIGHTS	45-0"
*ANCHOR LIGHT - BOW	97'-½"
*ANCHOR LIGHT - STERN P/S	55'-10⅛"
SIDE LIGHT - PORT - RED	66'-11"
SIDE LIGHT - STBD - GREEN	66'-11"
STERN LIGHT - PORT - WHITE	56'-3"
STERN LIGHT - STBD - BLUE	56'-3"
STEERING LIGHT	92'-9½"
*UNDERWATER TASK LIGHT - WHITE	134'-6¼"
WAKE LIGHT	55'-0"
AIRCRAFT WARNING LIGHTS	164'-3"
SPEED & AIRCRAFT WARNING LIGHTS	161'-0"
BLINKER LIGHTS ON YARDARM P/S	158'-3"
*MAN OVERBOARD & BREAKDOWN LIGHTS - RED	UPPER 140'-6½" LOWER 128'-5¾"
TOP OF AN/SPS-10D ANT	169'-2⅛"
HIGHEST FIXED POINT ON SHIP (FLANGE ON MAINMAST)	146'-0⅞"

* MEASURED DIMENSION

ACCOMMODATIONS

PERSONNEL	BEDS	BERTHS	BERTH LKRS	A-LKRS	K-LKRS	L-LKRS
CAPTAINS SEA CABIN		1				
CAPTAINS STATEROOM	1					
UNIT CDR STATEROOM	1					
CHIEF OF STAFF	1					
EXECUTIVE OFFICERS STATEROOM	1					
DIVISION CDR STATEROOMS		2				
OPERATIONS OFFICERS STATEROOM		1				
NAVIGATION OFFICERS STATEROOM		1				
MEDICAL OFFICERS STATEROOM		1				
ENGINEERING OFFICERS STATEROOM		1				
SUPPLY OFFICERS STATEROOM		1				
FIRST LIEUTENANTS STATEROOM		1				
CHAPLAINS STATEROOM		1				
WEAPONS OFFICERS STATEROOM		1				
REPAIR OFFICERS STATEROOM		1				
SUBMARINE COMMAND OFFICERS STATEROOM		2				
DENTAL OFFICERS STATEROOM		1				
MARINE OFFICER STATEROOM		1				
OFFICERS STATEROOMS		75				
CPO LIVING SPACES		117		117		
CREWS LIVING SPACES		1209	1209		5	36
TOTAL	4	1419	1209	117	5	36

SMALL BOATS

NUMBER	NAME	MEN EACH	TOTAL
2	26'-0" MOTOR WHALEBOATS MK 9	22	44
2	33'-0" PERSONNEL BOATS	24	48
2	50'-0" UTILITY BOATS	150	300
96	CO_2 INFLATABLE LIFEBOATS	15	1440
		TOTAL	1832

CRANE CAPACITIES

TRAVELING CRANES (4)
LIFTING CAPACITY
BOOM RETRACTED – 7000 LBS AT 37' RADIUS
BOOM EXTENDED – 3000 LBS AT 54' RADIUS
(BOOM EXTENSION BY HYDRAULIC CYLINDER UNDER NO LOAD ONLY)

KINGPOST CRANES (2)
LIFTING CAPACITY
MAIN HOOK – 95000 LBS AT 79' RADIUS
AUXILIARY HOOK – 12000 LBS AT 72' RADIUS

AS34-845-2105517
GENERAL INFORMATION
PLATE 2 OF 17

AN/BRA-17 ANT
175'-3" ABV ℄
SPEED & AIRCRAFT WARNING LT P/S 164'-3"
WHITE ROTATING BEACON LT 164'-3"
FLANGE 146'-0⅞" ABV ℄
UPPER MOB 140'-6-2"
UNDERWATER TASK LT 134'-6"4"
LOWER MOB LT 128'-5¾"
35' XMTNG ANT #3-1 (P) (AN/WRC-1) ANT CPLR CU-937/UR
3"/50 CAL TWIN MT
TRAVELING CRANE (P/S) PORT CRANE & TRACK ONLY SHOWN FOR CLARITY
40'-0" UTILITY BOAT P/S
33'-0 PERSONNEL BOAT P/S
50'-0 UTILITY BOAT P/S
KINGPOST CRANE (P/S)
TRAVELING CRANE (P/S)
BROADBAND UHF ANT AS-1018/URC #2-1
175'-9⅞" ABV ℄
HINGED FLANGE 169'-1⅞" ABV ℄
UHF ANT AS-390/SRC #2-9(S) & #2-10(P)
AS-936/SPS-10D 164'-2⅛" ABV ℄
ECM ANT AS-49A/APR-6 #5-5(℄)
LORAN "A" RCVG ANT AN/SRA-20 #4-1(S)
LORAN "C" RCVG ANT AN/SRA-17 #4-2(P)
YARDARM PLATFORM 157'-10½" ABV ℄
MATCHING NETWORK FOR ANT #2-3
AS-177/UPX ANT (AN/UPN-98 TEST) #3-2(S)
AS-177/UPX ANT (AN/UPX-17 IFF) #3-16(P)
NANCY BEACON ANTS T-940/SAT #6-2(S) #6-1(P)
UHF DIPOLE ANT AT-150/SRC #2-2(S)
VHF DIPOLE ANT NT 66095 #2-8(P)
HALYARD
FLANGE 141'-2⅞" ABV ℄
RANGE LT 137'-9⅞" ABV ℄
WIRE ROPE FAN XMTNG ANT #2-3 (P/S) (2-6 MC)
35' WHIP XMTNG ANT #2-5(S)
35' WHIP XMTNG ANT #2-6(P)
ECM ANT AS-899/SLR #5-12(S)
ECM ANT NT 66131 #5-8(S)
ECM ANT NT 66132 #5-7(P)
ECM ANT AS-616/SLR #5-10(S)
ECM ANT AS-571A/SLR #5-9(P)
RADAR PL 131'-2" ABV ℄
VLF-LF RCVG ANT AN/SRA-17 #1-2(S) & #1-1(P)
RADAR PL 120'-2" ABV ℄
MASTHEAD LT 124'-5¼"
TOWING LT (PORTABLE)
35' XMTNG WHIP ANT #2-4
CONE SHAPED RCVG ANT #1-4(S) & #1-5(P)
ECM ANT NT 66132 #5-6(S)
ECM ANT NT 66131 #5-9(P)
06 LEVEL 7'-6" ABV 05
ANT TUNER TN-342/WRT-2(P&S)
05 LEVEL 9'-0" ABV 04
04 LEVEL 8'-0" ABV 03
SIDE LT P/S
03 LEVEL 8'-0" ABV 02 LEVEL
02 LEVEL 8'-0" ABV 01 LEVEL
CONE SHAPED RCVG ANT #1-3(℄)
STEERING LT 92'-9½
FWD ANCHOR LT 97'-0½"
01 LEVEL 72'-11½" ABV ℄
MAIN DK
2ND DK
3RD DK
4TH DK
DWL 24'-0"
FULL LOAD LINE 21'-3¼" ABV ℄
1ST PLATFORM
2ND PLATFORM
INNER BOTTOM AT ℄
ACCOMODATION LADDER (P/S)
BOOT TOPPING
60'-0" SERVICE BOOM (P/S)
FENDER
AFT ANCHOR LT ℄ 79'-8⅛"
STERN LT WHITE (P)
STERN LT BLUE (S)
WAKE LT 55'-0"
40'-0" BOAT BOOM
FULL LOAD LINE 24'-3" ABV ℄
BOOTTOPPING
BILGE KEEL P/S
S34
158 156 154 152 150 148 146 144 142 140 138 136 134 132 130 128 126 124 122 120 118 116 114 112 110 108 106 104 102 100 98 96 94 92 90 88 86 84 82 80 78 76 74 72 70 68 66 64 62 60 58 56 54 52 50 48 46 44 42 40 38 36 34 32 30 28 26 24 22 20 18 16 14 12 10 8 6 4 2 FP A B C D

AS 34 - 845 - 2105517

OUTBOARD PROFILE

SCALE 1/16"=1'-0

PLATE 3 OF 17

MAINMAST
RAIL
HELICOPTER LANDING AREA
MAIN DECK CAMBER 6" IN 42'-6" 57'-0" ABV ℄ TO FR 59½ - SHEER FWD
2ND DECK DAMAGE CONT. DK NO CAMBER 45'-6" ABV ℄ TO FR 79½ - STR SHEER FWD
3RD DECK NO CAMBER 36'-0" ABV ℄ TO FR 59½ - STR SHEER FWD
4TH DECK NO CAMBER 28'-0" ABV ℄ TO FR 134
DWL 24'-0"
BASELINE
PASSAGE 1-134-2-L
BOS'N STOREROOM 2-151-0-A
PASSAGE 2-144-0-L
WHITE PRINT ROOM 2-139-2-Q
PASSAGE 2-134-2-L
S.D. STOREROOM 3-144-0-A
O2 N2 COMP RM 3-139-0-E
PASSAGE 3-134-0-L
STEERING GEAR ROOM 4-144-01-E
AFT CHAIN LKR 4-144-0-Q
S.D. STOREROOM MECH & ELEC REPAIR PARTS 4-134-0-A
PASSAGE 4-134-4-L
STORES CONVEYOR NO.8 (P) 4-134-2-T
VOID 5-144-01-V
VOID 5-151-0-V
VOID 5-144-01-Y
VOID 6-144-0-V
CHAIN LKR SUMP 5-144-0-W
3"/50 CAL AMMO MAG 5-139-0-M
3"/50 CAL HANDLG ROOM 5-139-0-M
TRUNK 5-134-0-T
VOID 6-134-4-V
F.O. SERVICE 6-134-2-F
FRESH WATER 7-129-2-W
SKEG INACCESSIBLE VOID
RESERVE FEED WATER 8-123-2-W
3"/50 R.S ROOM 02-132-0-M
FAN ROOM 01-132-0-Q
SHTMTL SHOP 1-123-0-Q
TOOL ISSUE ROOM 2-132-0-Q
UPTAKE 2-128-0-E
FIRE ROOM 7-123-0-E
GRATING 20'-0" ABV ℄
GRATING 11'-0" ABV ℄
TRASH BURNER ROOM 02-125-0-Q
MK 69 GFCS CONTROL ROOM 02-122-0-C
03 LEVEL 8'-0" ABV 02 LEVEL NO SHEER CAMBER W/01 LEVEL
ELECTRICAL SHOP 01-123-0-Q
NUC VENT EXH THRU MAST
NAVIGATION EQUIPMENT SHOP 01-110-01-Q
ELEV MACH ROOM 01-110-0-Q
SHEETMETAL SHOP 1-123-0-Q
SHIPFITTER & WELDING SHOP 1-110-0-Q
CARPENTER PATTERN SHOP 2-123-0-Q
MACHINE SHOP 2-100-0-Q
S.D. STOREROOM SUBMARINE REPAIR PARTS 3-110-0-A
36'-0" ABV ℄
ENGINE ROOM 7-110-0-E
GRATING 25'-0" ABV ℄
GRATING 13'-0" ABV ℄ (OUTBD OF 10'-0" OFF ℄ P/S)
GRATING 8'-0" ABV ℄ (INBD OF 10'-0" OFF ℄ P/S)
FRESH WATER 8-115-2-W
F.O. OR BALLAST 8-110-2-F
CARGO ELEV NO 2 6-108-0-T
TURBINE LUB OIL CARGO 7-106-0-FF
HATCH
FAN ROOM 01-107-0-Q
FLEET MECH CALIB LAB (AREA '5') 01-102-0-Q
MECH STD LAB (AREA 'A') 01-100-0-Q
ELECTRONIC T/E STOWAGE & OFF 01-97-0-Q
HYD TEST SHOP (TEST AREA) 1-106-2-Q
HYD TEST SHOP (CLEANING AREA) 1-100-2-Q
OUTSIDE MACHINE SHOP 1-96-0-Q
MACHINE SHOP 2-100-0-Q
PASSAGE 2-97-0-L
PIPE SHOP 3-100-4-Q
RADIO GRAPHIC DARK ROOM 3-102-2-Q
RADIO GRAPHIC VIEW. ROOM 3-100-0-Q
CHANGE ROOM 3-98-0-L
S.D. STOREROOM (ORD. REPAIR PARTS) 4-100-0-A
28'-0" ABV ℄
DECONTAMINATION ROOM 5-97-0-Q
S.D. STOREROOM BAR, PIPE, CABLE REEL & FOUNDRY STRM) 5-100-0-A
20'-0" ABV ℄
DEMINERALIZER ROOM 6-97-0-Q
FLAMMABLE GAS CYL. STRM 6-103-0-A
UNASSIGNED 6-100-0-A
FUEL OIL OR BALLAST 8-100-0-F
CONTAMINATED PARTS STRM 7-97-0-A
NUCLEAR TRUNK 7-94-0-T
MAST STOW. TRUNK
DOOR
UNASSIGNED 02-83-0-A
ELECTRONICS SHOP 01-90-0-Q
MECHANICAL INSTRUMENT SHOP 01-80-0-Q
02 LEVEL 75'-0" ABV ℄ AT ℄ NO SHEER CAMBER W/01 LEVEL
01 LEVEL 67'-0" ABV ℄ AT ℄ NO SHEER CAMBER W/MN DK
FAN ROOM 1-90-0-Q
STORES ASSEMBLY AREA 1-84-01-L
ELEV MACH'Y ROOM 1-84-0-Q
MISSILE HANDL'G EQUIP STRM 1-80-0-A
MAIL BAG STR'M 2-91-0-A
CREW RECREATION ROOM 2-85-0-Q
EDUCATIONAL SUPERVISOR OFFICE 2-80-2-Q
PIPE CLN'G ROOM 3-90-0-Q
CREW LIVING SPACE 3-80-0-L
SUBMARINE COMPONENT STOREROOM 4-90-0-A
S.D. STOREROOM (ELECTRONIC REPAIR PARTS ISSUE RM) 4-85-0-A
CARGO ELEV. TRUNK 7-85-0-T
I.C. & GYRO ROOM 4-80-0-C
S.D. STOREROOM SUB REPAIR PARTS (NUCLEAR) 5-90-0-A
S.D. STOREROOM ELECTRONIC REPAIR PARTS 5-80-0-A
S.D. SUBMARINE COMPONENT STRM 6-90-0-A
S.D. STOREROOM MECH & ELEC REPAIR PARTS 6-80-0-A
S.D. STOREROOM MECH & ELEC REPAIR PARTS 7-80-0-A
FUEL OIL OR BALLAST 8-90-0-F
FUEL OIL OR BALLAST 8-80-2-F
MAIN DECK
2ND DECK
3RD DECK
4TH DECK
1ST PLATF
2ND PLATF
FBM STOWAGE AREA 7-68-0-MM
F.O. OR BALLAST 8-72-2-F
F.O. OR BALLAST 8-68-0-F
OT FLAT 6.567 FT ABV ℄
CROSS FLOODING TRUNK
DECK HEIGHTS SHOWN BET FR'S 59½ & 79½ ARE FOR DECKS INBD 18'-0" LONG. BHD P/S.
WARD 01-60-0-L
FBM ELEV TRUNK 1-60-2-T
STATERM 1-66-2-L
STATERM 1-62-2-L
RE-ENTRY BODY SHOP & STOW. AREA 2-60-0-Q
ELEV MACHY RM 2-62-2-E
LAUNCH GAS GEN. STOW. 3-66-0-M
LAUNCHER TUBE DIAPHRAGM STOW 3-60-0-A
MISSILE GUIDANCE CHECKOUT & REPAIR 4-60-0-Q
HYDRAULIC CHECKOUT
PACKAGE AREA 5-62-2-Q
PASSAGE 5-60-0-L
REPAIR PARTS STORE ROOM 6-63-0-A
PASS 6-60-0-L
FBM TARGET DATA CARD STRM 7-63-0-C
RE-ENTRY SYS. COMP STRM 7-60-0-C
FUEL OIL OR BALLAST 8-60-2-F
PERISCOPE STOWAGE TRUNK 4-59-2-A
FAN ROOM 03-55-0-Q
RADIO XMTR ROOM 03-50-0-C
CONFERENCE & BRIEFING ROOM 02-55-0-L
DIV CDR OFF. 02-51-2-Q
OPERATING ROOM 01-56-0-L
SURGICAL DRESSING & MAIN BATTLE DRESSING STATION 01-52-0-L
MEDICAL XRAY RM 01-49-0-L
DENTAL OPER RM NO 2 01-46-2-L
DENTAL OPER RM NO 1 01-43-2-L
DENTAL OFF. STATEROOM 01-40-0-L
MARINE OFF STATEROOM 01-38-2-L
STATEROOM 01-34-2-L
STEWARDS MESS 01-31-0-L
WARDROOM GALLEY 01-25-0-Q
WARDROOM MESSROOM 01-17-0-L
AUTO DATA PROCESSING EQUIP ROOM 1-52-2-Q
CONSOLIDATED TECH LIBRARY 1-49-0-Q
DAMAGE CONT CENT 1-44-0-Q
SUP DEPT OFFICE (DISBURSING) 1-38-2-Q
CPO MESSROOM 1-28-0-L
CPO GALLEY & SCULLERY 1-24-0-Q
CPO LIVING SPACE 1-17-0-L
CREW MESSROOM 2-49-0-L
CREW MESSROOM 2-38-0-L
CREW GALLEY 2-31-0-Q
PASSAGE 2-28-0-L
BAK STRM 2-28-2-A
CREW LIVING SPACE 2-17-0-L
CREW LIVING SPACE 3-49-0-L
CREW LIVING SPACE 3-38-0-L
CREW LIVING SPACE 3-28-01-L
PASS 3-28-0-L
LAUNDRY 3-17-0-Q
TAILOR & DRY CLN'G SHOP 3-17-0-Q
MK 16/10 TORPEDO WORKSHOP 4-49-0-Q
TORPEDO ELEVATOR 7-47-0-T
CREW LIVING 4-38-0-L
DRY PROVISIONS STOREROOM 4-28-01-A
PASSAGE 4-28-0-L
EMERGENCY GENERATOR ROOM 4-20-0-E
PASSAGE 4-17-2-L
SUBROC WORKSHOP 5-49-0-Q
MK 45 (ASTOR) & MK 37 WORK SHOP 5-38-0-Q
FREEZE STOREROOM
PASSAGE 5-28
EMERGENCY GENERATOR ROOM 5-20-0-E
PASSAGE 5-17-2-L
SUBROC HAND. AREA 6-52-0-Q
SUBROC MOTOR MAGAZINE 7-55-0-M
MK 37 & MK 45 ASTOR TORPEDO BODY STOWAGE 7-38-0-A
CHILL STOREROOM 0° TO 35° 6-28-2-A
PASSAGE 6-28-0-L
DRY PROVISIONS STOREROOM 6-17-01-A
DRY PROVISION STR'M 7-28-0-A
ACCESS TRUNK 7-26-2-T
PUMP ROOM NO 1 7-17-0-E
FUEL OIL OR BALLAST 8-38-2-F
F.O. OR BALLAST 8-35-0-F
DIESEL OIL OVFL OR BALLAST 8-28-0-F
PATIKOMETER TRUNK (P) 8-28-2-Q
DIESEL OIL OR BALLAST (CARGO) 8-17-2-FF
SQUAD. FLAG OFFR. OFF. 04-49-0-C
SQUAD. COMM OFF 04-45-0-C
COMM OFFICE 04-38-01-C
CRYPTO RM. 04-35-0-C
C.I.C. 04-32-0-C
PILOT HOUSE 04-28-0-C
FAN ROOM 05-38-0-Q
SIGNAL SHELTER 05-36-0-Q
7'-6" ABV 05 LEVEL CAMBER SHEER W/01 LEVEL
BULWARK
STATEROOM 03-45-2-L
CHIEF OF STAFF STATEROOM 03-47-0-L
CHIEF OF STAFF CABIN 03-38-0-L
STATEROOM 03-34-0-L
UNIT CDR & CAPTAIN GALLEY 03-32-0-Q
UNIT CDR CABIN 03-28-2-L
05 LEVEL 32'-0" ABV 01 LEVEL CAMBER & SHEER W/01 LEVEL
04 LEVEL 24'-0" ABV 01 LEVEL CAMBER & SHEER W/01 LEVEL
03 LEVEL 16'-0" ABV 01 LEVEL CAMBER & SHEER W/01 LEVEL
STATEROOM 02-49-2-L
STATEROOM 02-47-2-L
REPAIR OFF. STATEROOM 02-44-1-L
SUB CO STATEROOM 02-43-1-L
SUB CO STATEROOM 02-40-1-L
FAN ROOM 02-37-2-Q
STATEROOM 02-33-2-L
STATEROOM 02-31-2-L
STATEROOM 02-28-2-L
PASSAGE 02-24-0-L
02 LEVEL 8'-0" ABV 01 LEVEL FWD FR 59½ CAMBER & SHEER W/01 LEVEL
01 LEVEL CAMBER 6" IN 42'-6" SHEER FWD FR 59½
72'-11½" ABV ℄
PASSAGE 1-5-0-L
WINDLASS ROOM 1-6-0-Q
BOSN STOREROOM 1-0-0-A
MAIN DECK CAMBER 6" IN 42'-6" SHEER FWD FR 59½
63'-3¾" ABV ℄
MARINE LIVING SPACE 2-11-0-L
SHIPS STORE STRM 2-6-2-A
UNASSIGNED 2-6-0-A
S.D. STOREROOM 2-8-0-A
2ND DECK DAMAGE CONTROL DECK NO CAMBER
52'-0" ABV ℄
PASSAGE 3-14-0-L
FLAMMABLE LIQUIDS STR'M 3-10-0-K
S.D. STR'M 3-6-0-A
S.D. STR'M 3-A-0-A
3RD DECK NO CAMBER
41'-0" ABV ℄
STORES CONVEYER NO.2 (P) 6-17-0-T
FLAMMABLE LIQUIDS STOREROOM 4-10-0-K
4TH DECK NO CAMBER
31'-0" ABV ℄
FLAMMABLE LIQUID STRM 5-10-0-K
ACID STRM 5-10-2-K
CHAIN LKR NO 2 6-8-0-Q
CHAIN LKR NO 1 6-6-0-Q
FORE PEAK 7-A-0-W
DWL 24'-0"
FLAMMABLE LIQUIDS STOREROOM 6-10-0-K
1ST PLATFORM NO CAMBER NO SHEER
20'-3" ABV ℄
LINE OF INACCESSABLE VOID 8-FP-0-V
2ND PLATFORM NO CAMBER NO SHEER
12'-0" ABV ℄
DIESEL OIL OVFL OR BALLAST (CARGO) 8-10-0-FF
SUMP TANK 7-6-0-W
VOID 8-6-0-V
NT
INNERBOTTOM AT ℄
4'-0"
BASELINE
155
150
145
140
135
130
125
120
115
110
105
100
95
90
85
80
75
70
65
60
55
50
45
40
35
30
25
20
15
10
5
FP
A
B
C
D
WT BHD
OT & WT BHD
OT

AS34-845-2105517
INBOARD PROFILE
SCALE 1/16"=1'-0

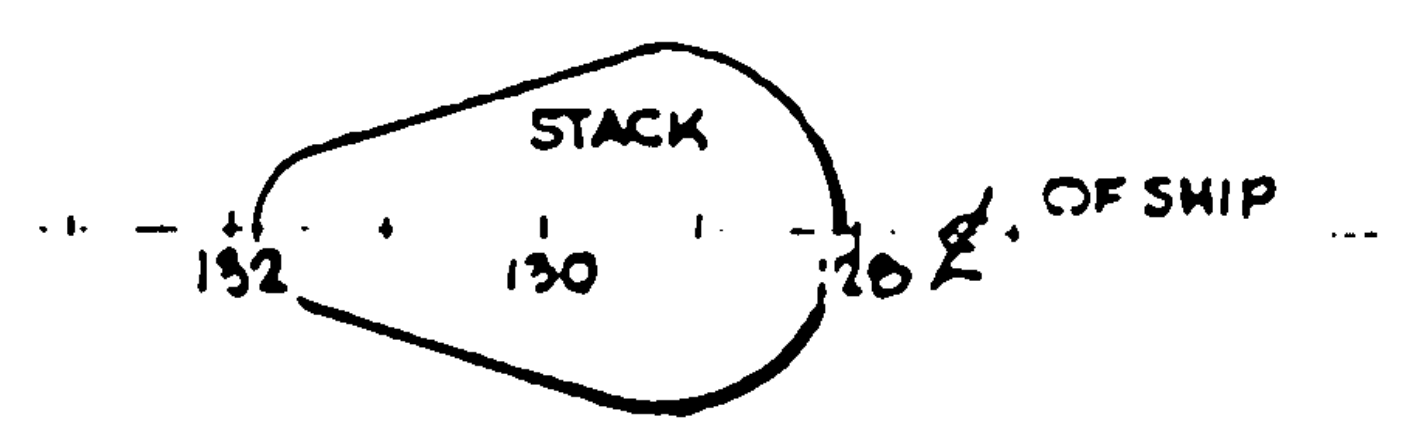

TOP OF STACK

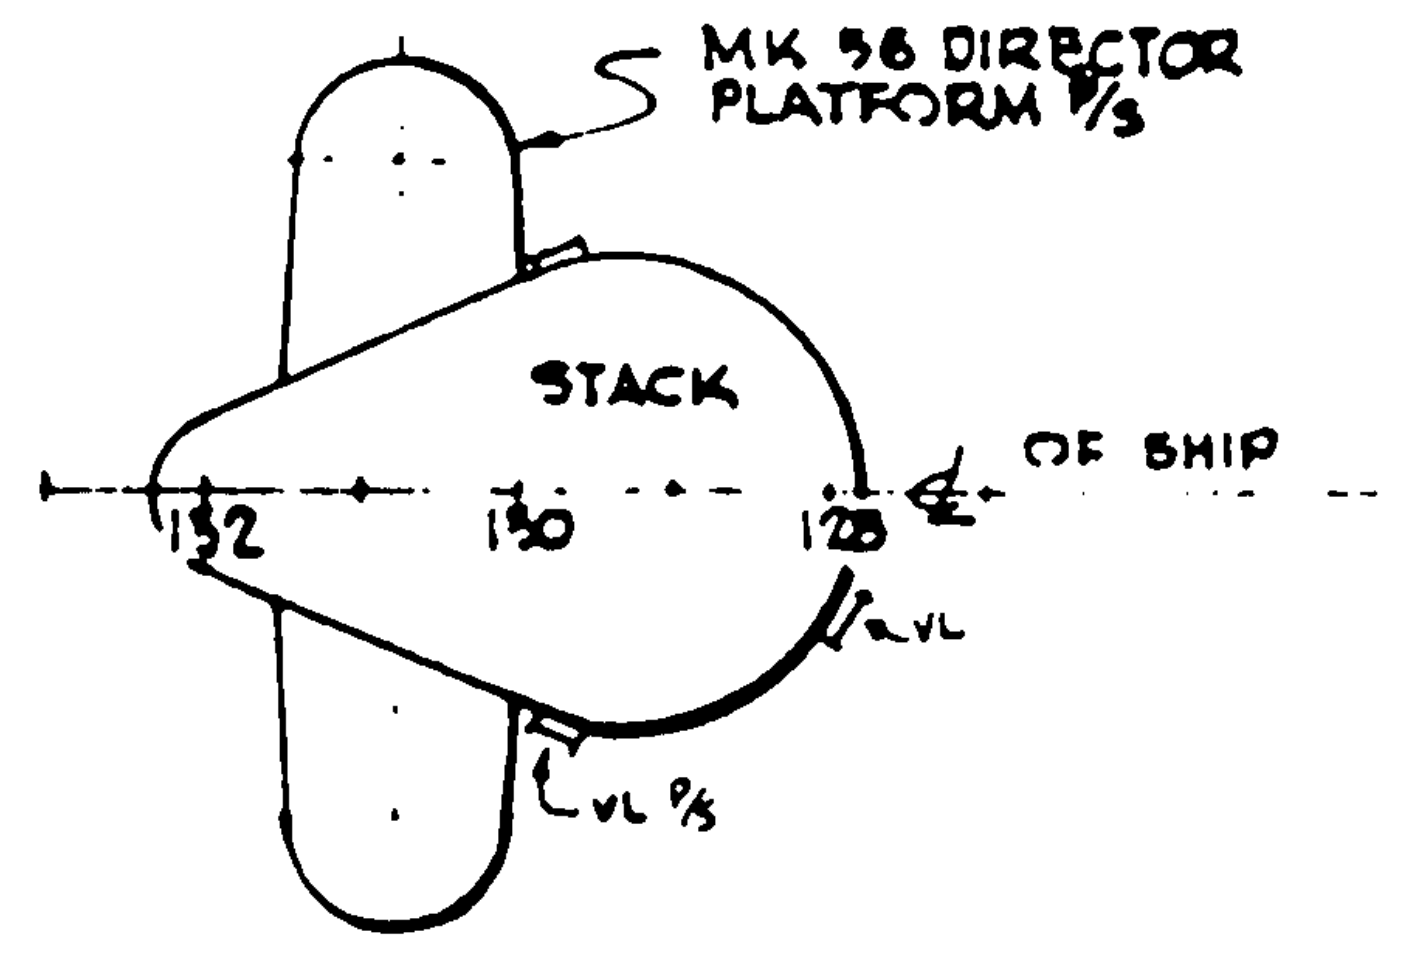

DIRECTOR PLATFORMS
05 LEVEL (32'-0" ABV 01 LEVEL)

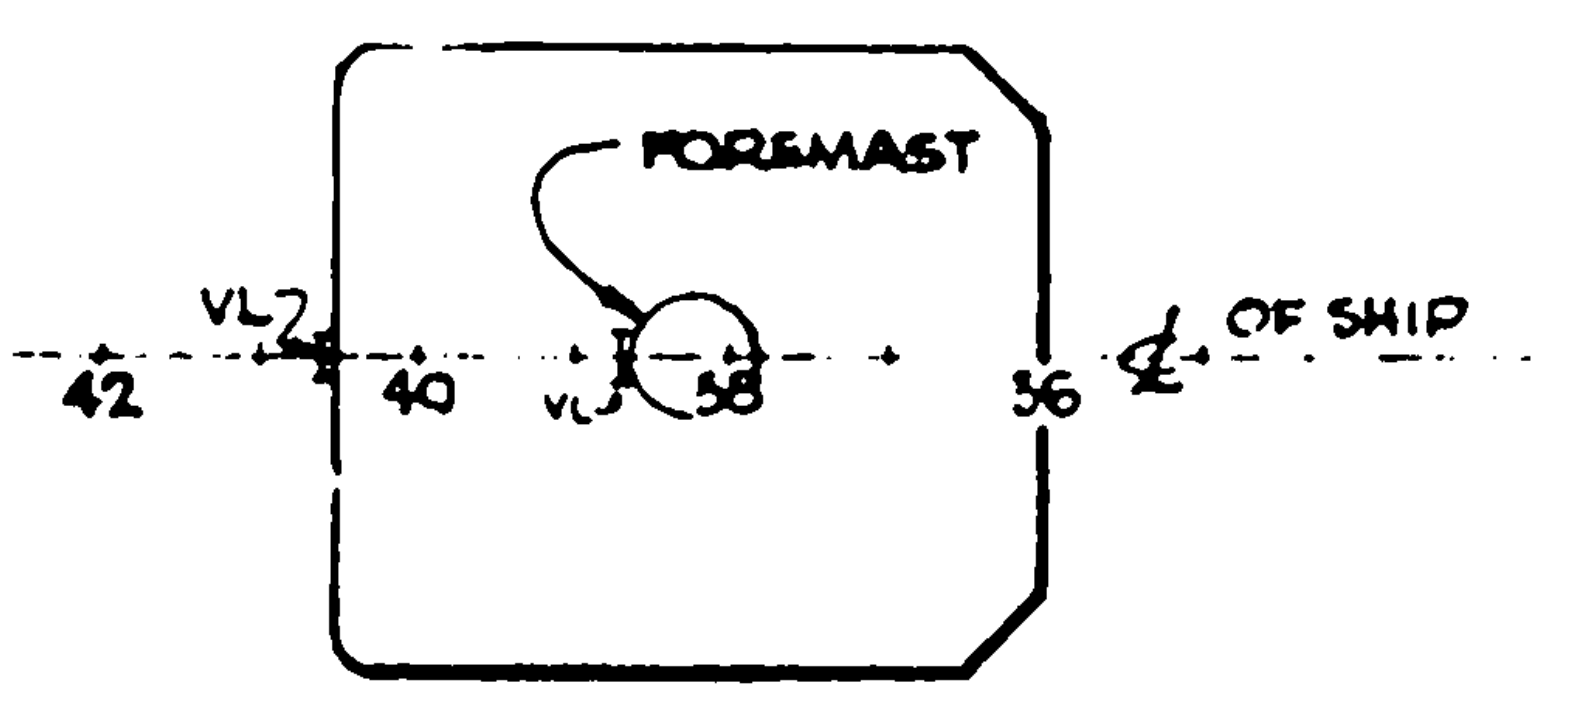

06 LEVEL
TOP OF FAN ROOM & SIGNAL SHELTER
7'-6" ABV & PARALLEL TO 05 LEVEL

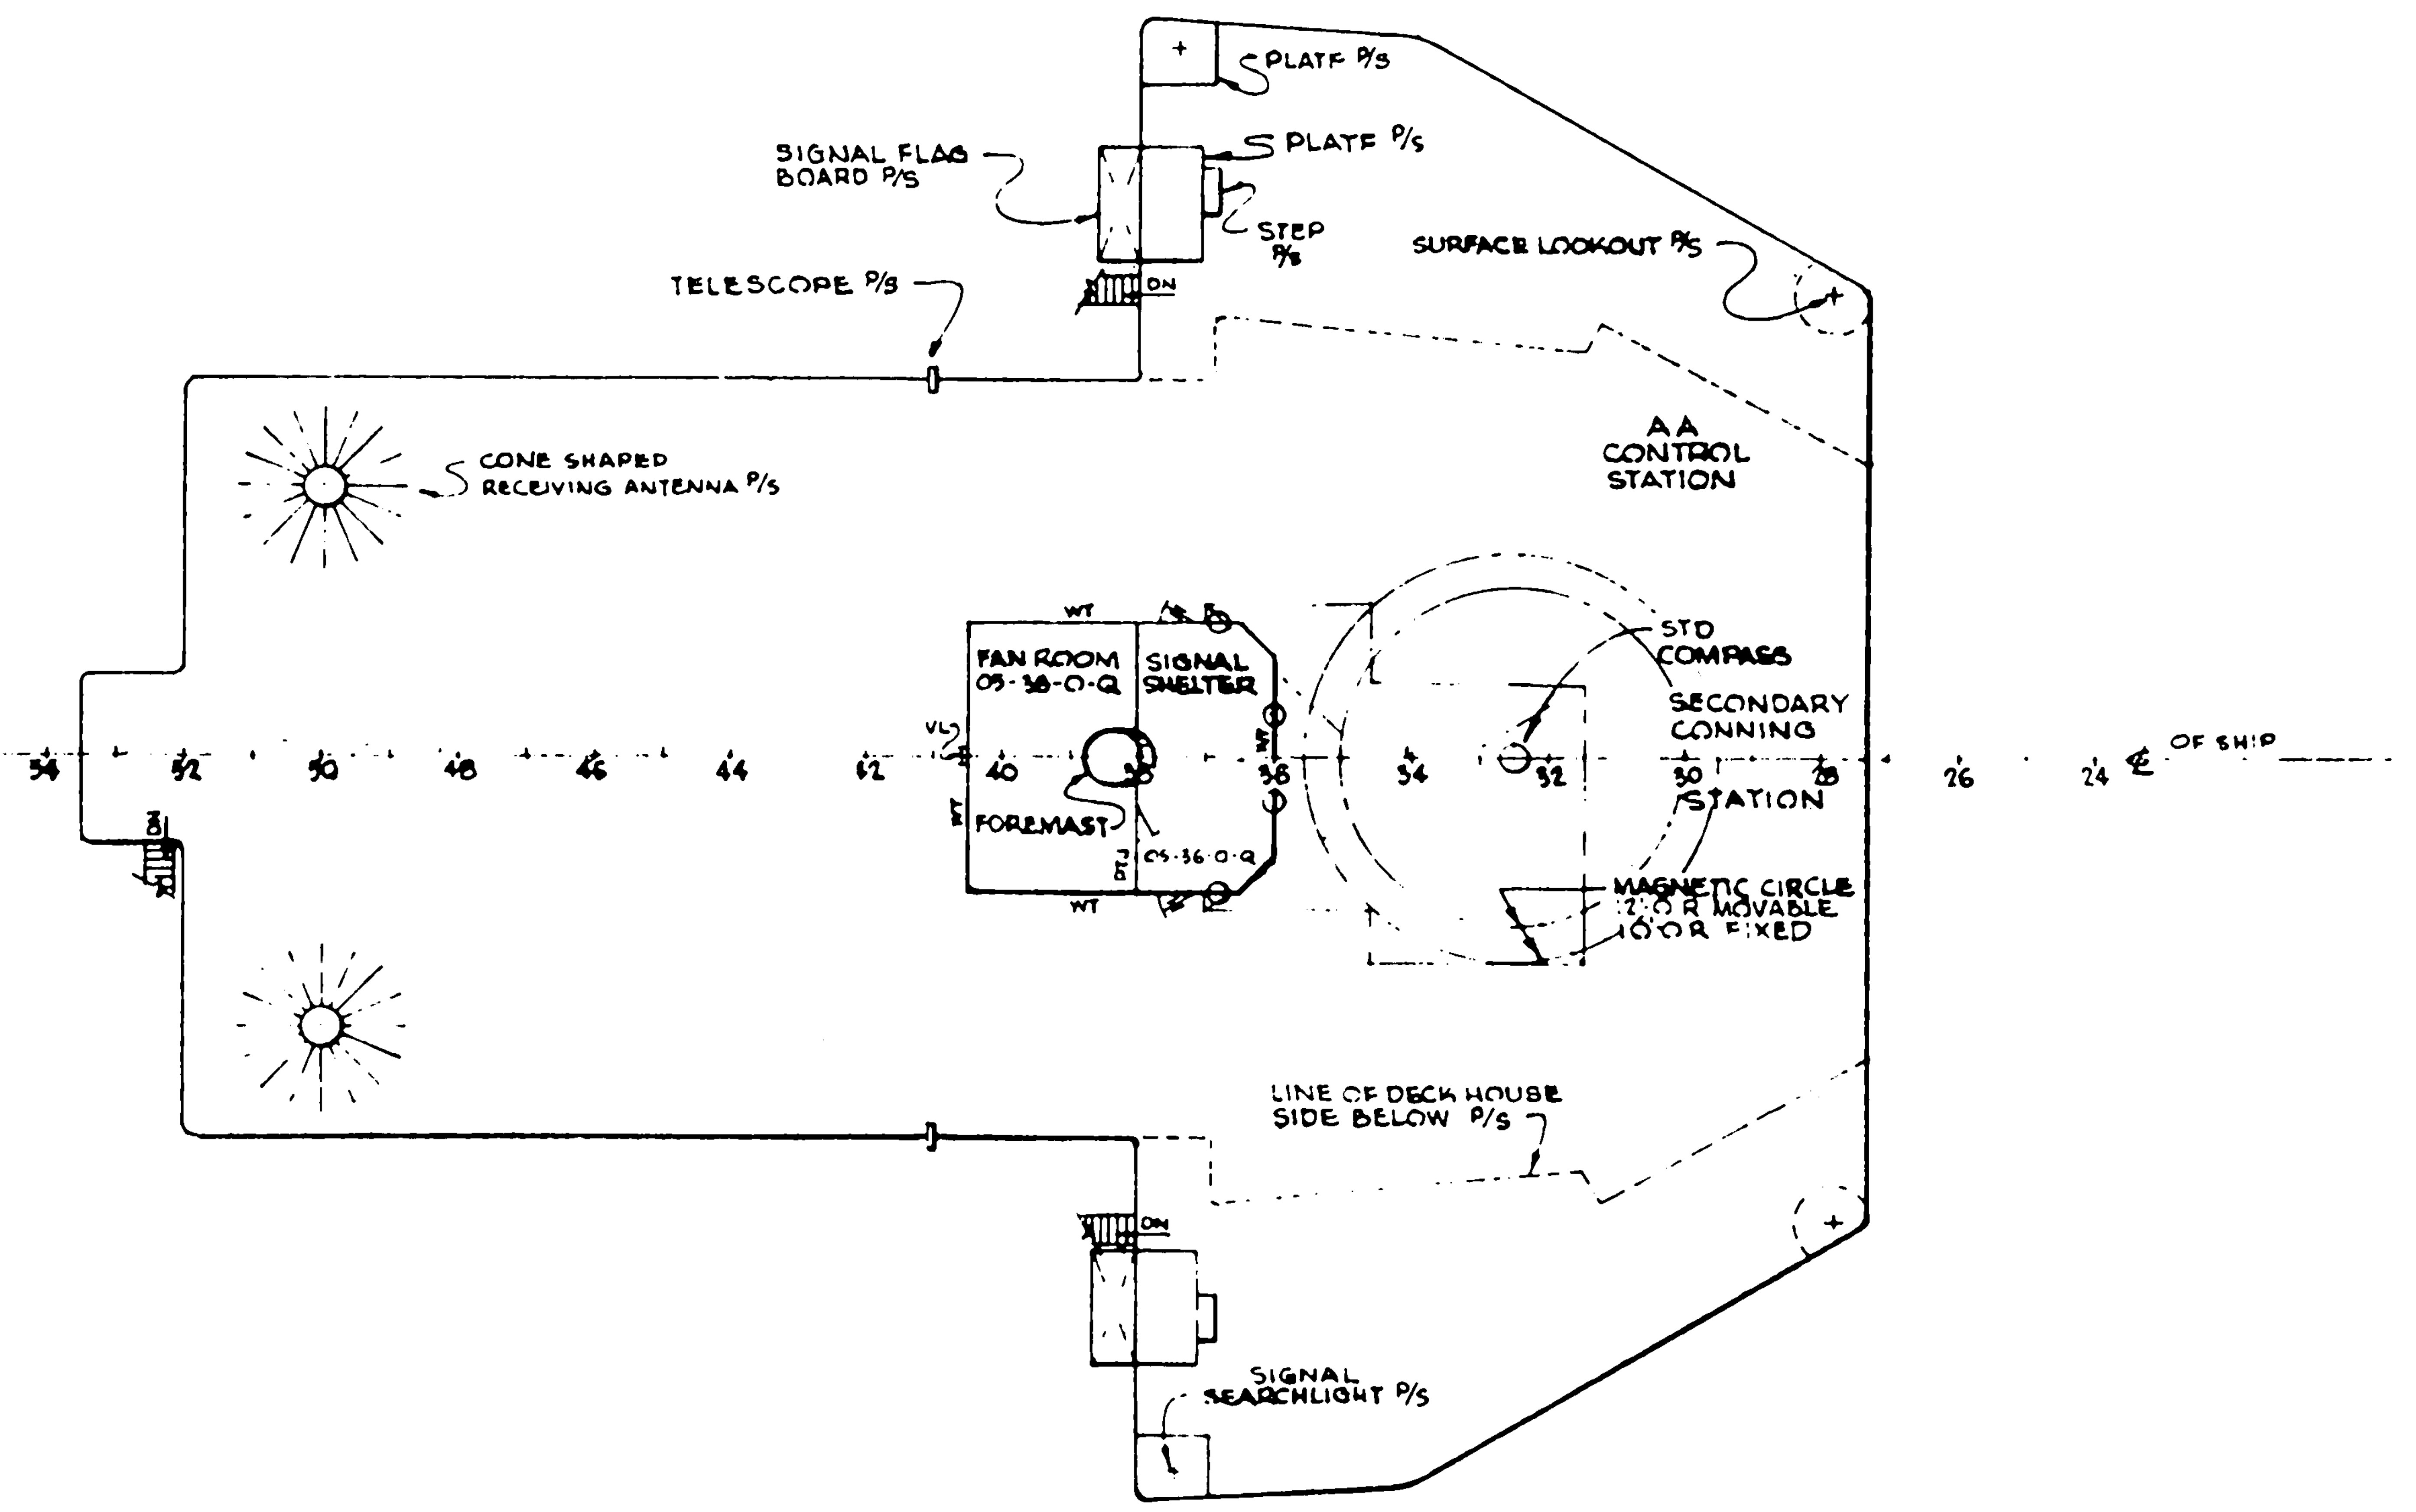

05 LEVEL

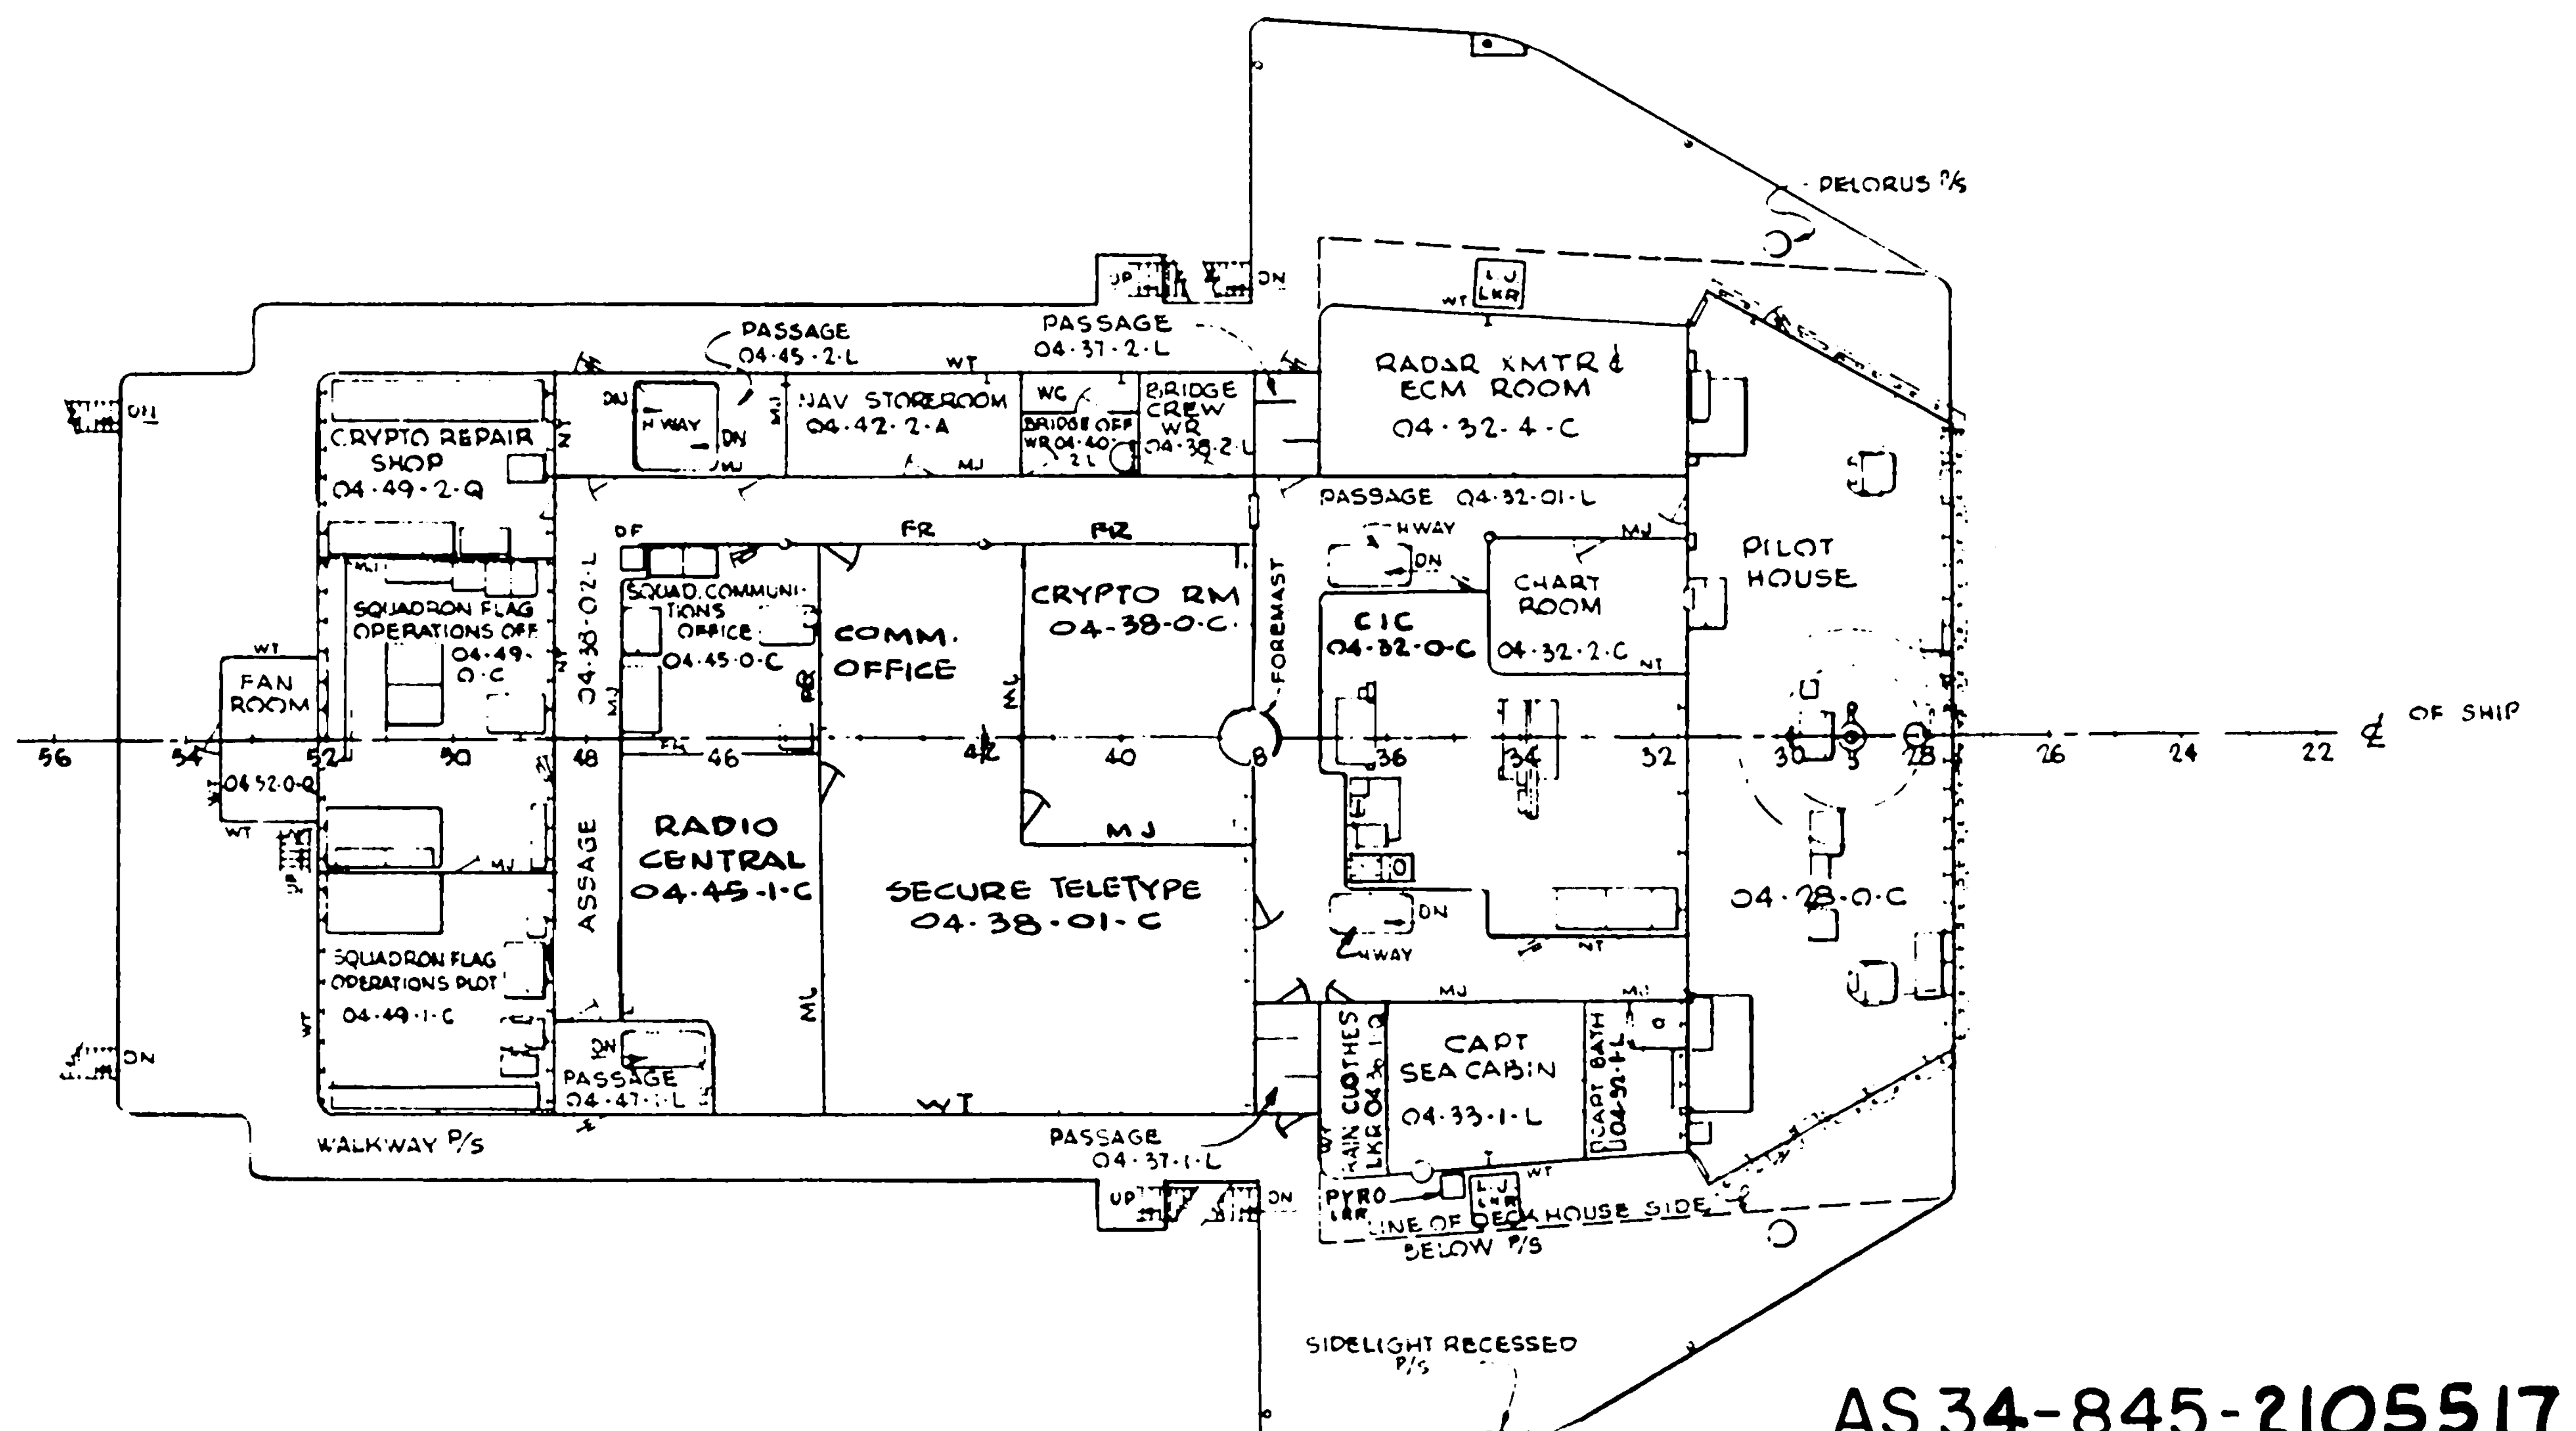

04 LEVEL

AS 34-845-2105517
04 LEVEL & ABOVE
SCALE 1/16"=1'-0"
PLATE 5 OF 17

AS 34-845-2105517
03 LEVEL
SCALE 1/16"=1'-0"
PLATE 6 OF 17

AS 34-845-2105517

02 LEVEL

SCALE 1/16"=1'-0"

PLATE 7 OF 17

AS 34-845-2105517

01 LEVEL

SCALE 1/16"=1'-0"
PLATE 8 OF 17

AS34-845-2105517
MAIN DECK
SCALE 1/16"=1'-0"
PLATE 9 OF 17

AS34-845-2105517
SECOND DECK
SCALE 1/16"=1'-0"
PLATE 10 OF 17

AS 34-845-2105517
THIRD DECK
SCALE 1/16"=1'-0"
PLATE 11 OF 17

AS 34-845-2105517
FOURTH DECK
SCALE 1/16"=1'-0"
PLATE 12 OF 17

AS 34-845-2105517
FIRST PLATFORM
SCALE - 1/16"=1'-0"
PLATE 13 OF 17

AS 34-845-2105517
SECOND PLATFORM
SCALE 1/16"=1'-0"
PLATE 14 OF 17

AS 34-845-2105517

HOLD

SCALE 1/16" = 1'-0"

PLATE 15 OF 17

AS 34-845-2105517

INNER BOTTOM

SCALE 1/16"=1'-0"

PLATE 16 OF 17

FR 154
PORT SIDE - LKG FWD

FR 143
PORT SIDE - LKG FWD

FR 126
PORT SIDE - LKG FWD

FR 116
PORT SIDE - LKG FWD

FR 77½
STBD SIDE - LKG FWD

FR 56
STBD SIDE - LKG FWD

FR 28
STBD SIDE - LKG FWD

FR 5
STBD SIDE - LKG FWD

AS34-845-2105517
MIDSHIP & TYPE SECT.
SCALE 1/8" = 1'
PLATE 17 OF 17